




AS-BUILT DIMENSIONAL PLAN - LOWER FLOOR
 SCALE: 1/8" = 1'-0"

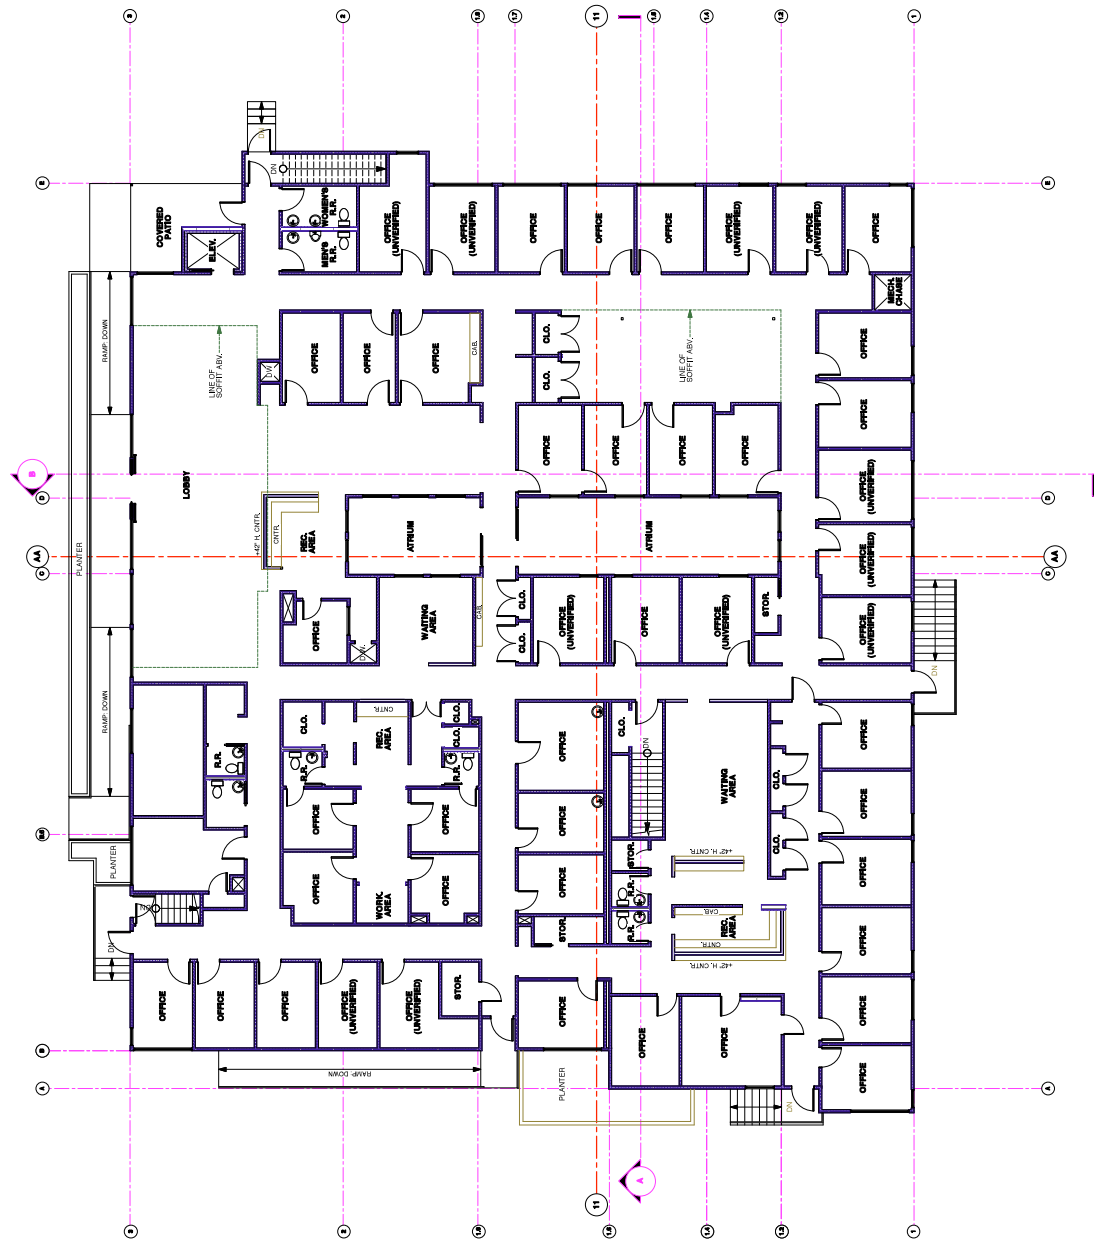


AS-BUILT DIMENSIONAL PLAN - UPPER FLOOR
 SCALE: 1/8" = 1'-0"

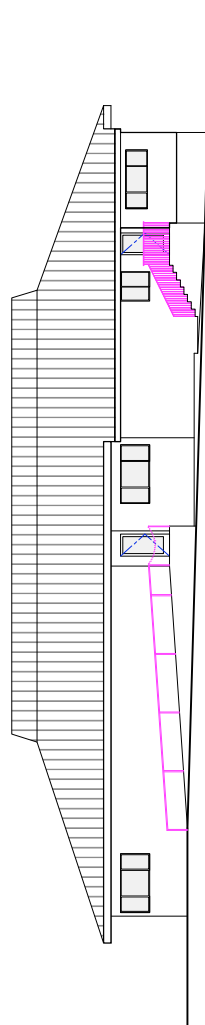


NORTH ELEVATION
 SCALE: 1/8" = 1'-0"

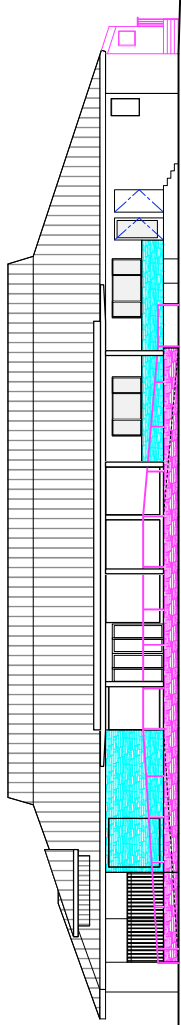

EAST ELEVATION
 SCALE: 1/8" = 1'-0"

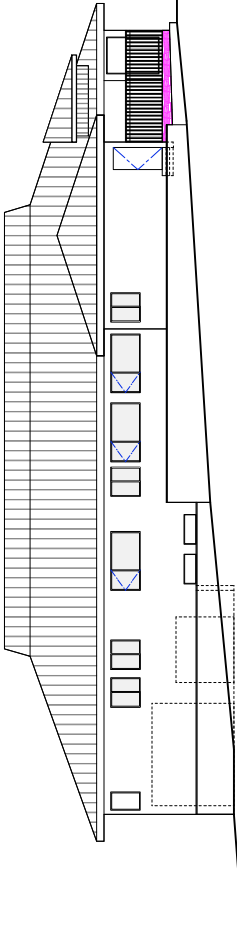

WEST ELEVATION
 SCALE: 1/8" = 1'-0"

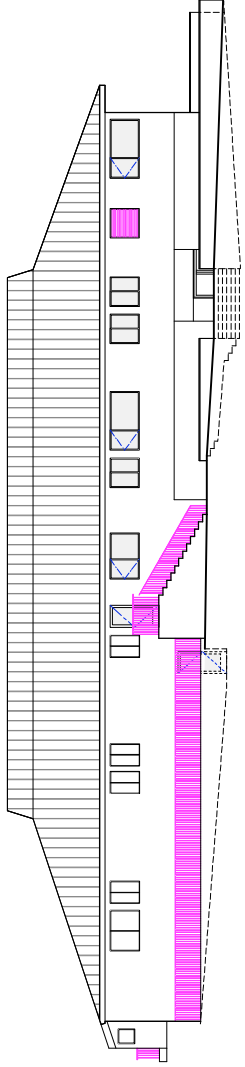

SOUTH ELEVATION
 SCALE: 1/8" = 1'-0"

AS-BUILT ELEVATIONS
 SCALE: 1/8" = 1'-0"